



A ELEVATION ALONG THE LONG SIDE (looking +X)

the whole rig end to end · scale 1 : 26

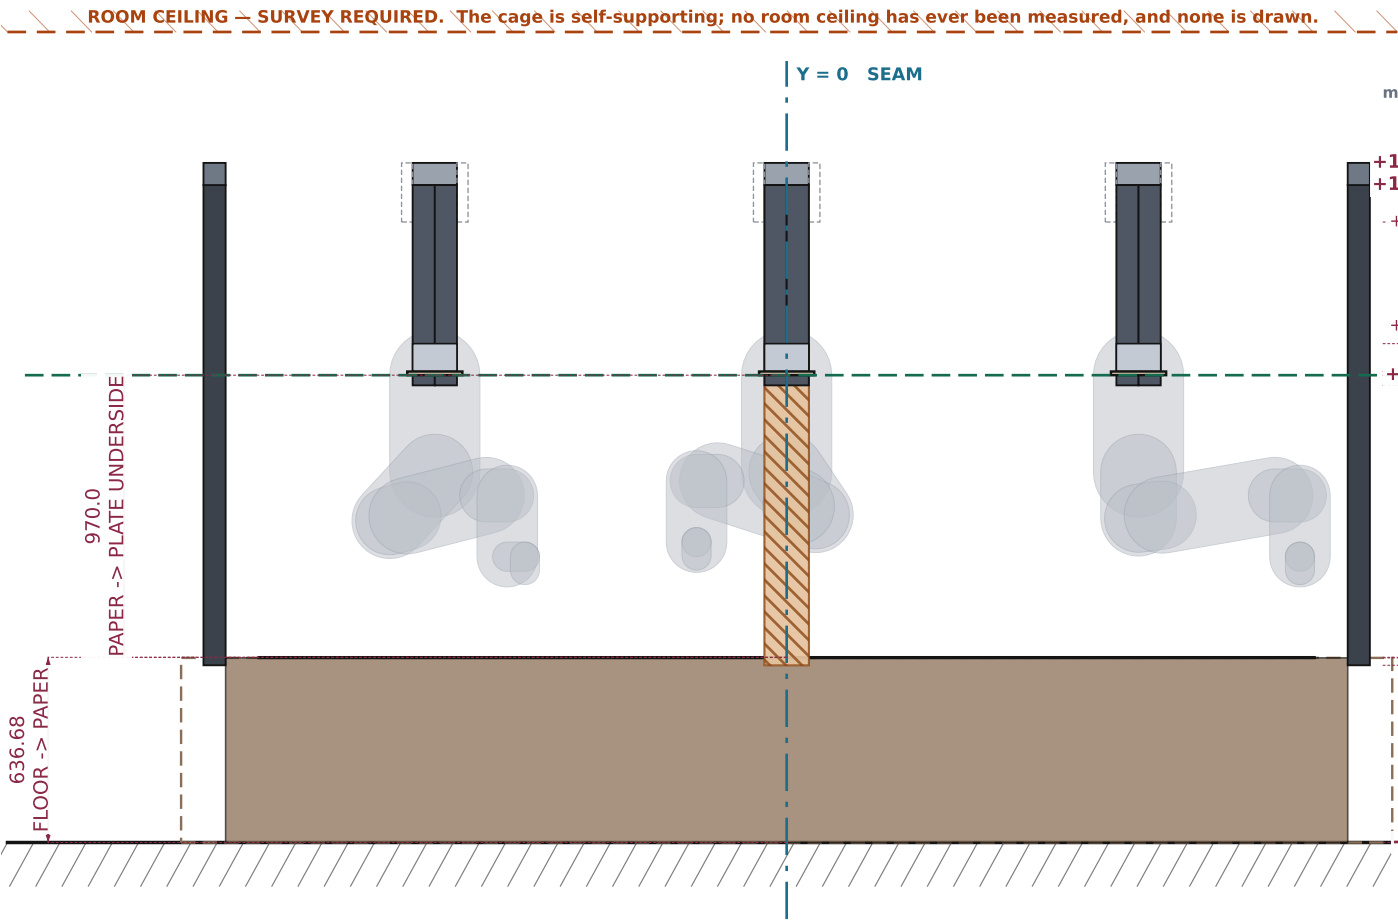

B ELEVATION ACROSS, AT THE SEAM (looking +Y)

scale 1 : 26

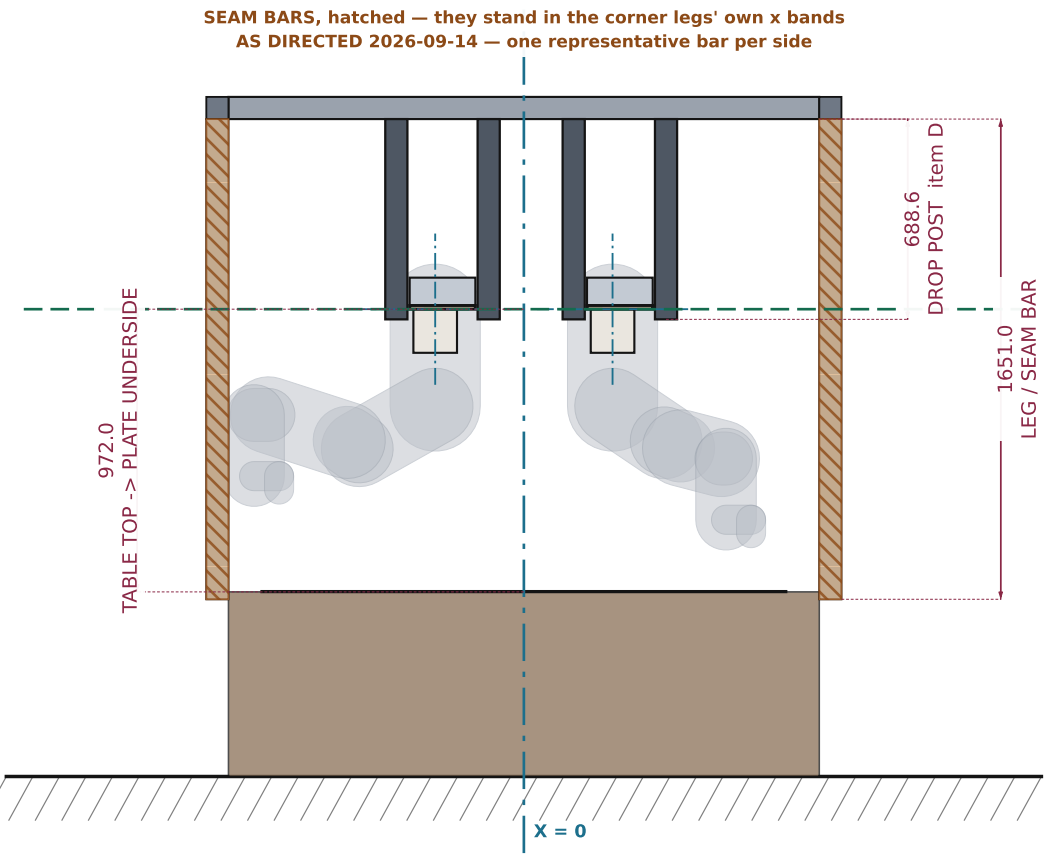

D REFERENCE HEIGHTS — FROM THE PAPER AND FROM THE FLOOR

	above PAPER	above FLOOR
TOP OF STEEL	+1699.82	2336.50
RUNWAY UNDERSIDE (posts hang from here)	+1623.62	2260.30
gusset bottom	+1496.62	2133.30
clamp top	+1078.40	1715.08
plate top	+982.70	1619.38
PLATE UNDERSIDE = mount plane h	+970.00	1606.68
drop-post bottom	+935.02	1571.70
PAPER TOP — the sheet-1/2 datum, 0	+0.00	636.68
table top	-2.00	634.68
corner-leg and seam-bar foot	-27.38	609.30
FLOOR — the tape datum	-636.68	0.00

CUT LENGTHS ON THIS LADDER

D drop post	688.6	(1623.62 - h) + 34.98, 24 off
E corner leg	1651.0	leg foot -27.38 to rail underside 1623.62, 4 off
I seam support bar	1651.0	the same cut as a corner leg, 2 off

E CHECKS YOU CAN MAKE WITH A TAPE AND NOTHING ELSE

FLOOR → PLATE UNDERSIDE

stand the tape on the floor under an arm and read the steel the arm bolts to. The single most useful check on the rig.

TABLE TOP → PLATE UNDERSIDE

same reading from the table instead of the floor, for when the paper is down and the floor is not reachable.

FLOOR → TABLE TOP

the table's own height — the drawing's 63,5 cm. If this is not what your tape says, EVERY paper-referenced number on sheets 1 and 2 moves by the difference.

FLOOR → TOP OF STEEL

the whole cage, and it is the original drawing's own 233,7 cm.

TOLERANCE, AND WHAT TO DO WITH A DISAGREEMENT.

Build to +/-10 mm per arm and keep the six mount planes mutually coplanar within +/-3 mm (BUILD_SHEET section 1). If a tape reading and this sheet disagree by more than that, RECORD THE AS-BUILT NUMBER — do not re-centre the other five arms to it, and do not edit the model to match a single reading.

NOTHING ON THIS SHEET IS A SURVEY.

Every height descends from the original drawing's 233,7 cm, read as FLOOR to top of a self-supporting cage. The room has never been measured.

C TWO DATUMS

PAPER TOP = 0

what sheets 1 and 2 and every module in the repo measure from.

FLOOR = 0, i.e. + 636.68

what a tape standing on the floor reads. The right-hand column of panel D is the same ladder with the floor as zero.

THE FLOOR COLUMN IS NOT A SURVEY.

It is the paper column plus 636.68, and that 636.68 is the drawing's table height, not a measured one. Check it first (panel E) — if it is not 635 the whole column shifts.

REV A — SUPERSEDES THE 1435 / 1525 DROP POSTS of out/ceiling_8020_layout.* — that grid datum read the drawing's 233,7 cm (FLOOR to top of cage) as if it were measured from the paper. DO NOT CUT FROM THE OLD SHEET. CENTRE-DATUM SET — sheets 3 and 4 dimension the SAME model from the TABLE CENTRE, signed. They do not supersede sheets 1 and 2; those are set-out from the canvas corner, these are for a tape at the built rig.

ARIS · six inverted FR3 over a horizontal paper table

SIDE REFERENCE HEIGHTS

sheet 4 of 4 · A3 · all dimensions mm · scales as noted

DESIGN MOUNT PLANE h

970.0 mm

above the paper top surface

DROP POST item D

688.6 mm

= (1623.62 - h) + 34.98, 24 off

DATUM

paper top 0 · floor 636.68

table top -2.0 · top of steel 1699.82

DATE

2026-09-16

scripts/draw_8020.py · read-only against the package